

State of California
State Water Resources Control Board
DIVISION OF WATER RIGHTS
1001 I Street, 14th Floor, Sacramento, CA 95814
P.O. Box 2000, Sacramento, CA 95812-2000

Info: (916) 341-5431, Fax: (916) 341-5400, www.waterboards.ca.gov/waterrights

INITIAL STATEMENT OF WATER DIVERSION AND USE

NOTE: A Statement is not a Water Right

This Statement should be typewritten or legibly written in ink and submitted to the address above.

A separate statement must be filed for each point of diversion.

An (*) indicates a required section. Required sections must be completed for the Statement to be accepted.

***A. Claimant/Agent Information**

Claimant/Owner: Colusa Properties, Inc	Agent: Benjamin F. Carter
Mailing Address	Mailing Address
4746 River Road	P.O. Box 212
Colusa, CA 95932	Colusa, CA 95932
Phone No. 530-458-4476	Phone No. 530-458-7566
Fax No. 530-458-4475	Fax No. 530-458-7571
E-mail Address: janefostercarter@gmail.com	E-mail Address: bencarter@succeed.net

***B.** Water is diverted and used under the claim of: Riparian claim ☒ Pre 1914 claim ☐ Court Decree No. _____
Note, if you have an application on file for a water right or have an existing license, please provide your application number _____
Other (explain): _____

***C.** Name of the body of water at the point of diversion

Sacramento River

Tributary to _____

***D.** Point of diversion is located within **Colusa** County on Assessor's Parcel No. **12-220-23**
being within the **NW** 1/4 of **NW** 1/4 of Section **19**, of Township **17**, Range **1W**, **MD** B&M.

Provide the location of the point of diversion using the California Coordinate System (NAD 1983) or Latitude / Longitude measurements.

Sacramento River Mile 101.8L

Identify the point of diversion and outline the place of use on a United States Geological Survey (USGS) topographic map and submit the map with the Statement.

Name of the diversion works is **P-200 River** Related Water Right(s) _____

E. Do you own the land at the point of diversion? Yes ☐ No ☐ If No, please provide the name and address of the land owner at the point of diversion: _____

***F.** Capacity of diversion works **3000 gpm** (cfs, gpm, or gpd) Capacity of storage tanks or reservoir **0** (gallons or acre-feet)

Type of diversion facility: Gravity ☐ Creek Pump ☒ Well Pump ☐

Method of measurement: Weir ☐ Flume ☐ In line flow meter ☒ Electric Meter ☐ Estimate ☐

NOTE: [#]Monthly report below is optional until January 1, 2012, at which time the information becomes mandatory.

[#]Provide the maximum rate of diversion achieved in each month in the table below as measured in: cfs ☐ gpm ☐ or gpd ☐

Year	Jan	Feb	Mar	Apr	May	June	July	Aug	Sept	Oct	Nov	Dec

Additional copies of this form and water right information can be obtained at www.waterboards.ca.gov/waterrights.

S019619

*G. Provide the quantity of water diverted each month in the table below as measured in: Gallons ☐ Million gallons ☐ Acre-feet ☒

Year	Jan	Feb	Mar	Apr	May	June	July	Aug	Sept	Oct	Nov	Dec	Total Annual
2009													0

H. Annual water use in recent years: Maximum _____ (gallons or acre-feet) Minimum _____ (gallons or acre-feet)

State the year of first use at diversion site or storage facility _____

*I. Beneficial water use is for: (example, number of acres and type of crop irrigated, average number of persons served, number of stock watered, etc.) 200 acres of grains, vegetables, dry beans

*J. General description and location of the place of use shall be identified using a USGS topographic map, or if assigned, may be provided using the public land description to the nearest 40 acre parcel accompanied by the County Assessor's parcel map.

Approximately 200 acres due east of the P200 diversion comprising APNs 12-220-23, 12-220-24, and portion of 12-220-05 in sections 17,19, 20 of T17N, R1W, MDB&M

K. Please answer only those questions below that are applicable to your project.

1. Conservation of water
 - a. Describe any water conservation efforts you have in place _____
2. Water quality and wastewater reclamation
 - a. Are you now or have you been using reclaimed water from a wastewater treatment facility, desalination facility or water polluted by waste to a degree that unreasonably affects such water for other beneficial uses? YES ☐ NO ☒
3. Conjunctive use of surface water and groundwater
 - a. Are you using groundwater in lieu of surface water? YES ☐ NO ☒

I declare under penalty of perjury that the information in this report is true to the best of my knowledge and belief.

*DATE: 6/24/10 _____ at Colusa _____, California

*SIGNATURE: 

*PRINTED NAME: Benjamin F. Carter
(first name) (middle initial) (last name)

COMPANY NAME: Colusa Properties, Inc.

GENERAL INFORMATION PERTAINING TO WATER RIGHTS IN CALIFORNIA

There are two principal types of surface water rights in California. They are riparian and appropriative rights.

A riparian right enables an owner of land bordering a natural lake or stream to take and use water on his riparian land. Riparian land must be in the same watershed as the water source and must never have been severed from the source of supply by an intervening parcel without reservation of the riparian right to the severed parcel. Generally, a riparian water user must share the water supply with other riparian users. Riparian rights may be used to divert the natural flow of a stream but may not be used to 1) store water for later use 2) divert water which originates in a different watershed 3) divert water released from storage, or 4) divert return flows from groundwater use.

An appropriative right is required for use of water on non-riparian land and for storage of water. Generally, appropriative rights may be exercised only when there is a surplus not needed by riparian water users. After the formation of the California Water Commission in December 1914, new appropriators have been required to obtain a permit or license from the State.

Statements of Water Diversion and Use must be filed by a riparian and/or pre-1914 appropriative water user. The filing of a statement 1) provides a record of water use, 2) enables the State to notify such users if someone proposes a new appropriation upstream from their diversion, and 3) assists the State in determining if additional water is available for future appropriators.


The above discussion is provided for general information. For more specific information concerning water rights, please visit the website http://www.waterboards.ca.gov/waterrights/water_issues/programs/diversion_use/, or write to this office.

S019619

Additional copies of this form and water right information can be obtained at www.waterboards.ca.gov/waterrights.

UNITED STATES
DEPARTMENT OF THE INTERIOR
GEOLOGICAL SURVEY

MOULTON WEIR QUADRANGLE
CALIFORNIA-COLUSA CO.
7.5 MINUTE SERIES (TOPOGRAPHIC)

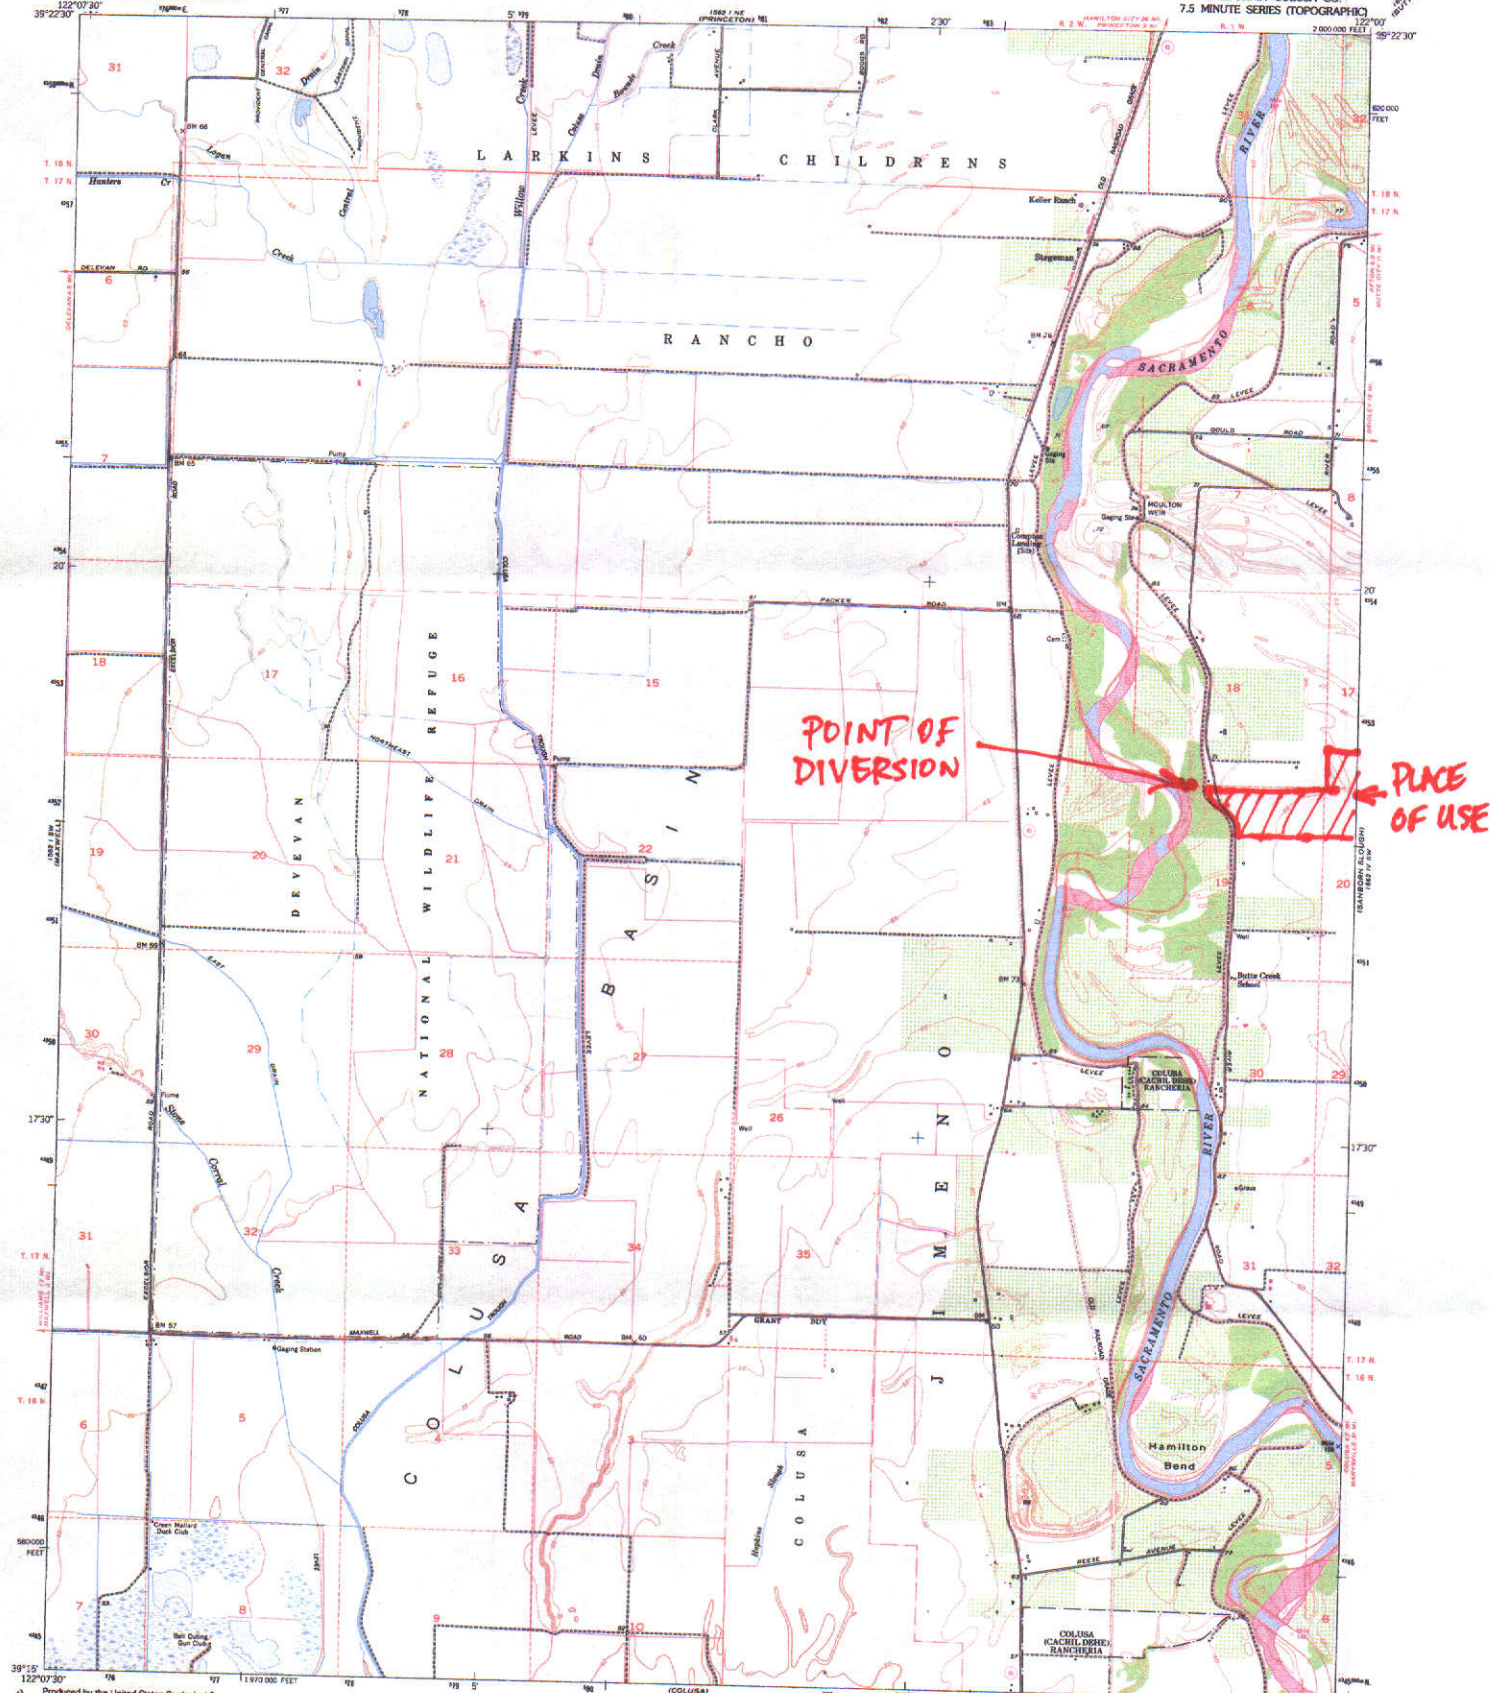

POINT OF
DIVERSION

PLACE
OF USE

ROAD CLASSIFICATION
Primary highway, hard surface
Secondary highway, hard surface
Unimproved road
Interstate Route
U.S. Route
State Route

MOULTON WEIR, CA

36123 C-17-024
1981
DATA 1562 2 SE-GENES 1985


S019619

COLUSA PROPERTIES, INC P200 RIVER

2 OF 2

UNITED STATES
DEPARTMENT OF THE INTERIOR
GEOLOGICAL SURVEY

SANBORN SLOUGH QUADRANGLE
CALIFORNIA
7.5 MINUTE SERIES (TOPOGRAPHIC)
SW-4 BUTTE CITY 11 QUADRANGLE

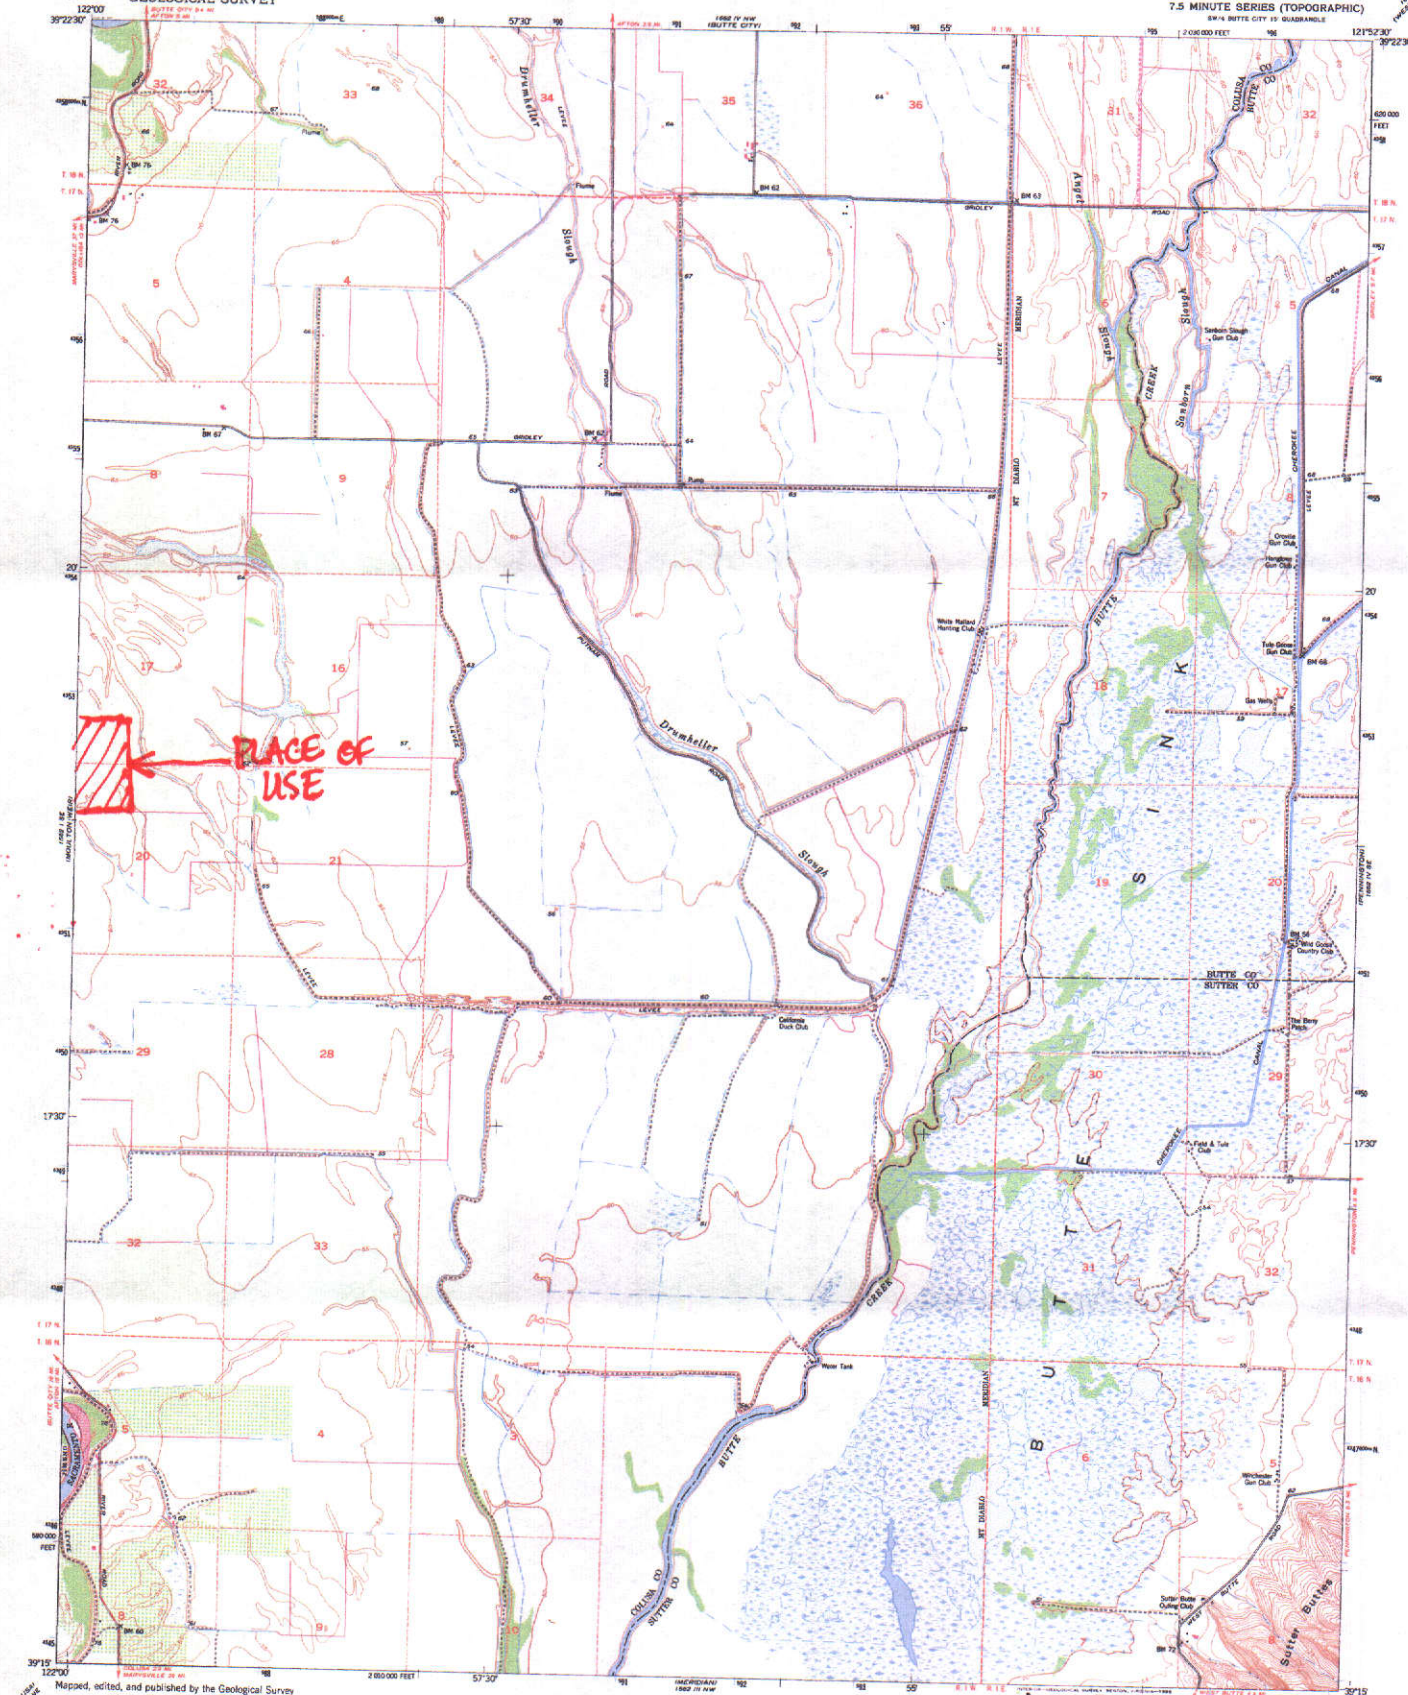

Maped, edited, and published by the Geological Survey
Control by USGS

Maped 1910, remapped 1952
Culture and drainage from photo mosaic by USBR
Aerial photographs taken 1949
Topography from prime table surveys by USGS 1952
Polyconic projection, 1927 North American datum
63,000 feet grid based on California coordinate system, zone 2
1000 meter Universal Transverse Mercator grid ticks,
zone 10, shown in blue

To place on the projected North American Datum 1983
move the projection lines 12 meters north and
96 meters west as shown by dashed corner ticks.
Dashed lines indicate approximate locations.



SCALE 1:24000

CONTOUR INTERVAL 5 FEET
CONTOURS INCOMPLETE ALONG BOUNDARIES AND DITCHES
NATIONAL GEODETIC VERTICAL DATUM OF 1929

THIS MAP COMPLEIES WITH NATIONAL MAP ACCURACY STANDARDS
FOR SALE BY U.S. GEOLOGICAL SURVEY, DENVER, COLORADO 80225, OR RESTON, VIRGINIA 22092
A FOLDER DESCRIBING TOPOGRAPHIC MAPS AND SYMBOLS IS AVAILABLE ON REQUEST



ROAD CLASSIFICATION
Heavy-duty ——— Light-duty ———
Medium-duty ——— Unimproved dirt ———
U.S. Route ——— State Route ———

SANBORN SLOUGH, CALIF.

SW-4 BUTTE CITY 11 QUADRANGLE
39121-C8-11-004

1952
PHOTOGRAPHED 1973
DMA 1983 (BY SW-SERIES 1988)

Revisions shown in purple and recapitulation of
woodland areas compiled in cooperation with
California Department of Water Resources from
aerial photographs taken 1973. This information
not field checked.